


MONUMENT RECORD

Corner ID: **Per_O21**


Section Corner

Sections 27 & 34- T08N-R01W, 2nd P.M. Perry Township, Monroe County, Indiana

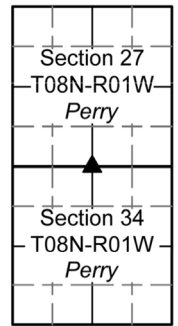

MONUMENT: Describe monument set or found (Include material type, scribing, distance above/below grade, dimensions.) Railroad Spike found 0.3' below grade approximately 1' north of centerline of Rayletown Road.

MONUMENT LOCATION SKETCH:

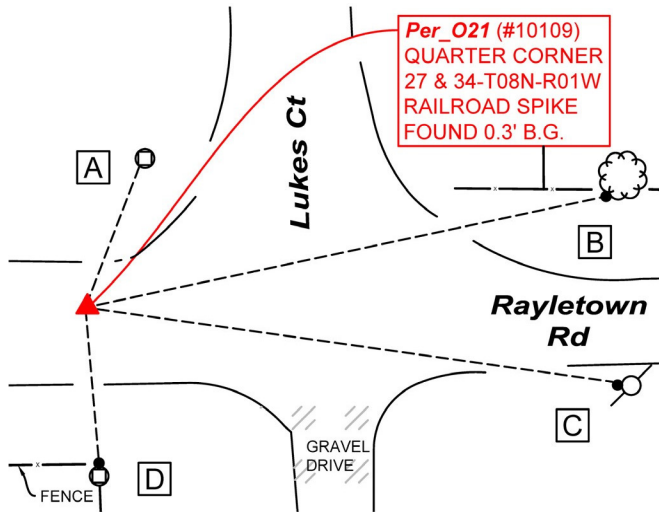

WITNESS MONUMENT TIES

All ties to new Bearing Trees (BTs) are a mag nail set in a 1-1/2" plastic washer stamped "SURVEY MARKER - DO NOT REMOVE" and hack mark at the root crown (less than 12" above ground) perpendicular to the center of the tree, unless otherwise noted. BT diameters are noted as dbh and are measured approximately 4.5' above ground. Distances are measured from the monument to the mag nail.

ID	BEARING	DISTANCE	DESCRIPTION
Witness A	N 21d E	24.2'	Center back of post supporting "STOP" sign measured at a point 8' above grade.
Witness B	N 78d E	85.0'	Mag nail and washer set in hack on the southwest side of a 30" Hackberry tree 1' above grade. Bearing and distance to mag nail.
Witness C	S 82d E	84.98'	Mag nail and washer set on west side of 11" utility pole 0.5' above grade. Bearing and distance to mag nail.
Witness D	S 5d E	24.1'	Found mag nail supporting "Protect Nearby Survey Markers" sign on north side of a 7" x 5" x 7.4' railroad tie fence post 6' above grade as per Witness D 2011 monument record.



OFFICE OF THE MONROE COUNTY SURVEYOR • Trohn Enright-Randolph

119 W 7th Street, Bloomington, IN 47404 • 812-349-2570 • surveyorsoffice@co.monroe.in.us

Page 1 of 3

MONUMENT RECORD

Corner ID: **Per_O21**

Section Corner

Sections 27 & 34- T08N-R01W, 2nd P.M. Perry Township, Monroe County, Indiana

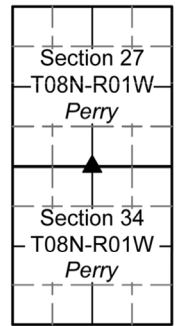


PHOTO IDENTIFIED: Photo Date: 7/29/2022



Photo Orientation & Description: Looking down at Per_O21



Photo Orientation & Description: Looking east at Per_O21

ORIGINAL OR SUBSEQUENT SURVEY EVIDENCE FOUND: Include, search area or areas, search procedure, etc.

Date of Field work/Search: 7/29/2022 By: JG & HJ Monument Found: Railroad Spike BTs or Reference Objects Found: Found Witness D. Witnesses B & C obliterated Project #: Perry Preservation and Restoration Field Book: 54/74 Equipment: The basis of bearings is Grid North System NAD83(2011)/Indiana West NAVD 88, Epoch 2010.0000, geoid12b_conus.db3, US Survey Feet, derived from GPS observations utilizing the Indiana Real-Time Network (INCORS). Coordinate data was collected with a Javad Triumph LS Network Rover. Coordinates are available upon request. Distances to witness ties were collected with a Leica Disto laser distance meter and 100' measuring tape. Bearings to witness ties were collected with the internal magnetic compass of the Javad Triumph LS and were automatically adjusted to grid north and are approximately shown hereon for reference. Priority should be given to provided distances over bearings. Notes: All witness photos on file in the Monroe County Surveyors Office.

OTHER EVIDENCE: Describe corner location relative to nearby features and how to reach the corner location – note fences, roads, timber cutting lines, mow lines, clearings, plantings, streams, topo changes, etc.

The monument was found northwest of 2022 Rayletown Road; just west of Rayletown Road's intersection with Luke Court.

MONUMENT PRESERVATION: Describe work done to preserve existing monument.

Geodetic coordinates were collected for the monument. Three new witnesses were established.

THEORY OF LOCATION: Describe the theory of location for acceptance of this monument. Include monument origin and associated uncertainty.

The previous monument record accepting the railroad spike as Per_O21 was approved by the Monroe County Surveyor, Kevin Enright, on September 19, 2007 and accepted by the Monroe County Surveyor Review Board on September 3, 2011. The 2011 Monument Record accepted the railroad spike per Monroe County Surveyor Michael W. Friley's 1994 Monument. Before the 2011 certification, the railroad spike was witnessed by Monroe County Surveyor, Steven V. Farkas, on November 10, 2004, with work performed by licensed surveyor Eric L. Deckard (LS 29900012). At the time, East Lukes Court was known as Lucas Court, dedicated in a plat by Steven W. Archer, Rachel's Meadow Subdivision Final Plat (2000), on file at the Recorder's Office as 2000001401.IN. The




OFFICE OF THE MONROE COUNTY SURVEYOR • Trohn Enright-Randolph

119 W 7th Street, Bloomington, IN 47404 • 812-349-2570 • surveyoroffice@co.monroe.in.us

Page 2 of 3

Corner ID: **Per_021**

Sections 27 & 34- T08N-R01W, 2nd P.M. Perry Township, Monroe County, Indiana

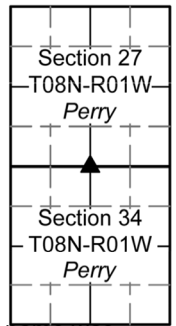

amended in an affidavit filed by Monroe County Planner and Address Coordinator, Ana Burns, on file at the Recorder's Office as 2000019270.IN. Before the 2004 Monument Record's completion, Monroe County Surveyor, Michael W. Friley, witnessed the railroad spike on May 23, 1994.

Also, a Charles D. Graham survey, Fields/Lucas Minor Subdivision Final Plat (2021), on file at the Recorder's Office as 2021009420.IN. Historic research has not yet been performed to prove the validity of this monument.

Donna Patricia

Survey Review Board



John E. F.

Monroe County Surveyor



MONUMENT RECORD
State of Indiana - County of Monroe

Section: 27


Township: 8 North

Range: 1 West

Corner ID: Per O-21

Monument Description & Remarks: R.R. Spike 4" below ground in centerline of Rayletown Road. Surveyor Sign on post at pt. D

References On File: Michael W. Friley recovery tie drawing, Monument Record Per O-21 (1994), on file in Surveyor Office

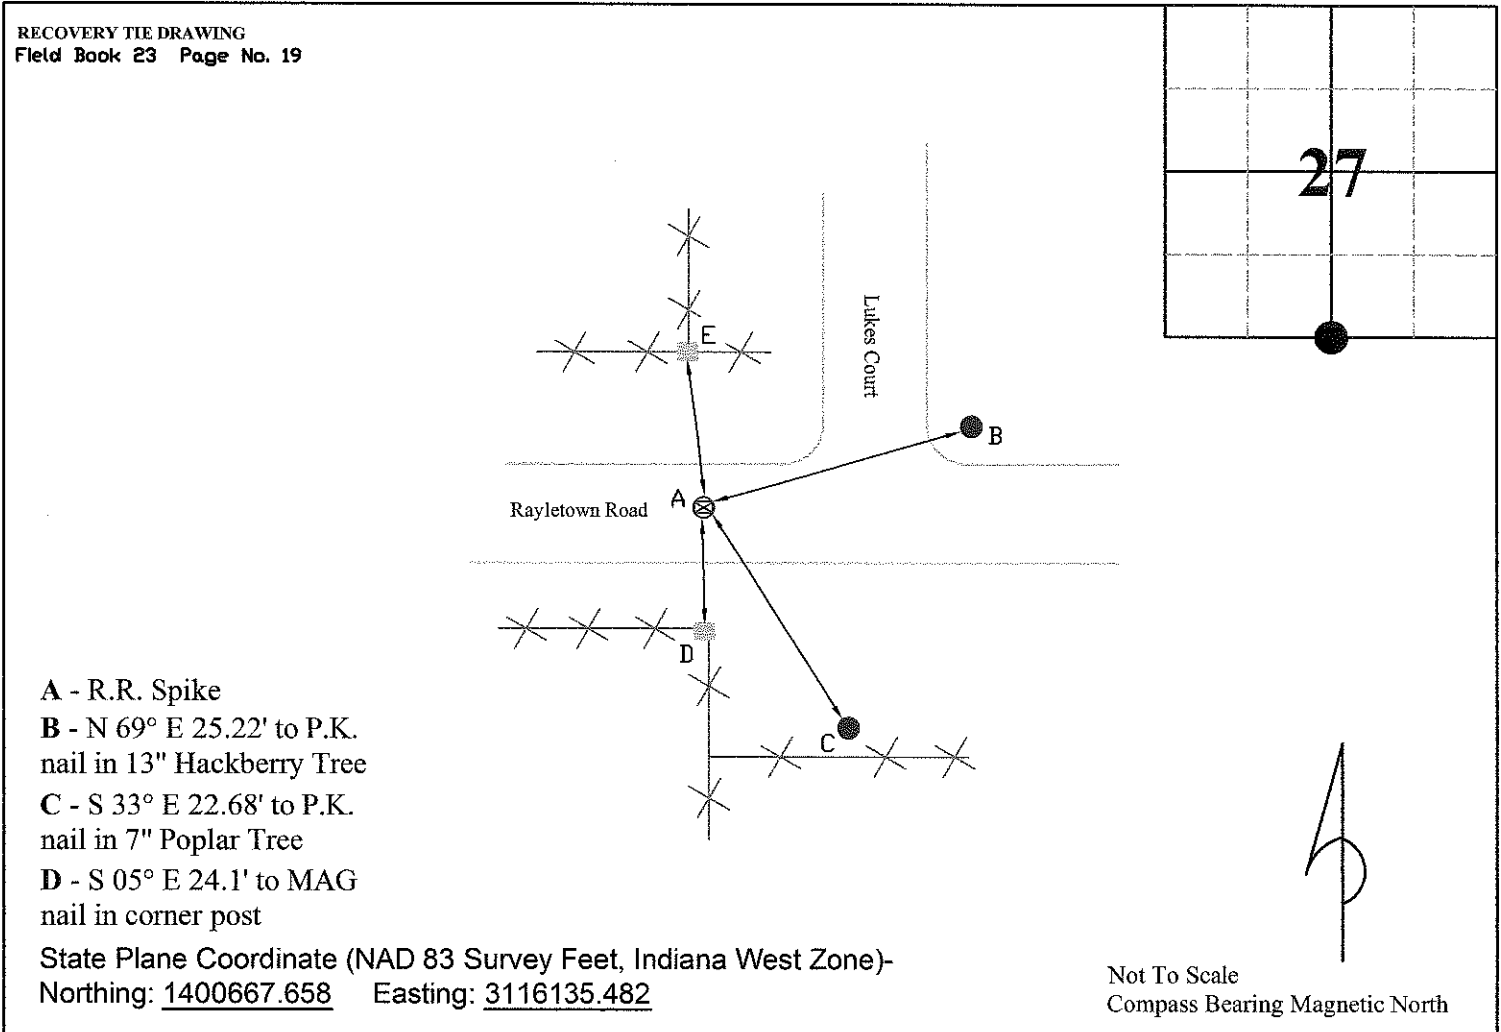

I, Kevin P. Enright, Monroe County Surveyor, hereby certify that this document was prepared under my direction in accordance with the provisions of section 36-2-12-11 of the Indiana Code; and the above data is given under my hand and seal this 19th day of September, 2007.

Kevin P. Enright

Administered by the Monroe County Surveyor Review Board

Date: 9-13-11



MONUMENT RECORD

STATE OF INDIANA-COUNTY OF MONROE


Section: 27, Township: 8 NORTH, Range: 1 WEST,

Monument Description & Remarks: R.R. SPIKE FOUND 3" BELOW PAVEMENT

MARKING THE SOUTH 1/4 OF SECTION 27

Recovery Tie Drawing

- A=✕ R.R. SPIKE
- B=■ P.K. NAIL IN POST 3' UP
- C=○ P.K. NAIL IN SW SIDE OF 10" POPLAR
- D=■ MAG NAIL IN CORNER POST 6" UP

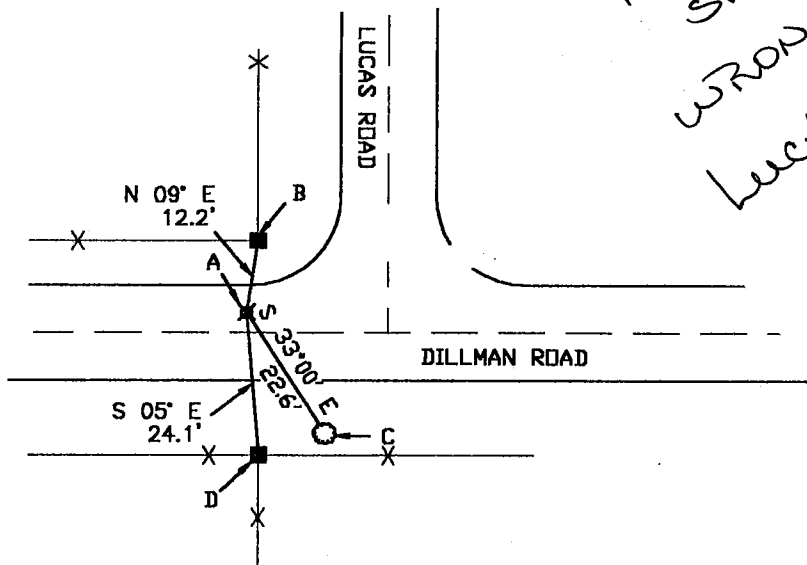

This tie sheet is wrong... No Lucas Rd. HERE.

(Refer to W7 tie sheet attached)

Section Corner: R.R. SPIKE

Northing: 1400667.658 Easting: 3116135.482

State Plan Coordinate (NAD83 Survey Feet, Indiana West Zone)

I, Eric Lee Deckard, here by certify that this document was prepared under my direction in accordance with the provisions of Section 17-3-64-4 through 17-3-64-8 of the Indiana Code, being Acts of 1965, Chapter 319, this 10th day of NOVEMBER, 2004 A.D.

Completed by Steven V. Farkas, Monroe County Surveyor

[Signature]

Indiana Registered Land Surveyor No. LS 29900012



MONUMENT RECORD


Corner I.D. #

O-21

STATE OF INDIANA - COUNTY OF MONROE

Section Twenty-seven, Township 8 North, Range 1 West

Monument Description & Remarks: Found Railroad Spike in centerline of
Dillman Rd. Spike was flush w/pavement. South 1/2 mile section corner.

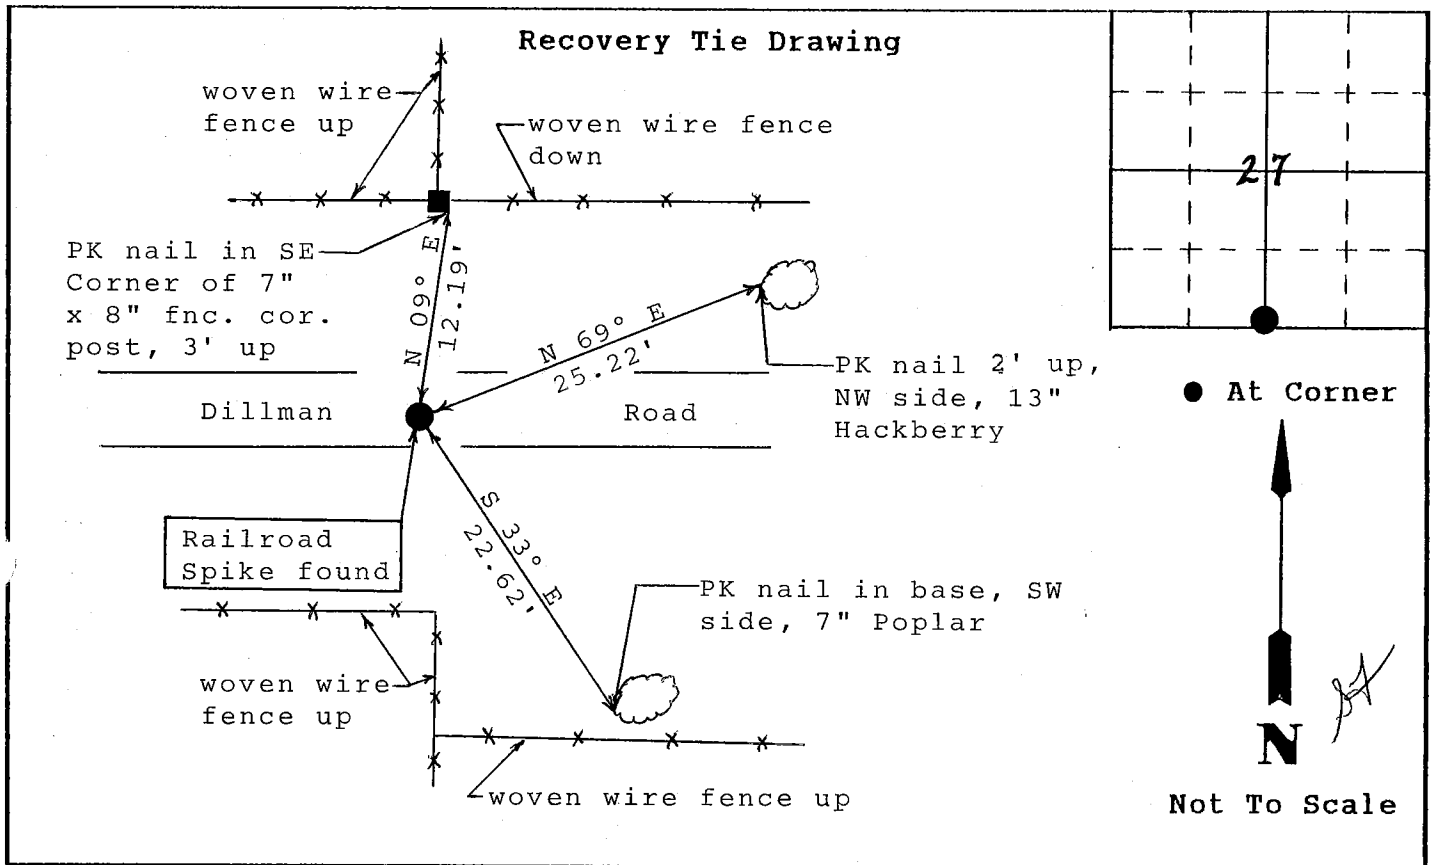

State of Indiana
County of Monroe

I, Michael W. Friley, County Surveyor, hereby certify that this document was prepared under my direction in accordance with the provisions of Section 17-3-64-4 through 17-3-64-8 of the Indiana Code, being Acts of 1965, Chapter 319; and the above data is given under my hand and seal this 23rd day of May, 1994 A.D.

Space
Reserved For
Recording
Officer

Indiana Registered Land Surveyor No. _____ or

Monroe County Surveyor's Office
United States Government Agency

Monroe County Surveyor
Title _____

Field Book:

94-01

Page:

19